






Roofing:

Roofing iron sheets
Timber truss system
Un plastered expanded metal lathe ceiling

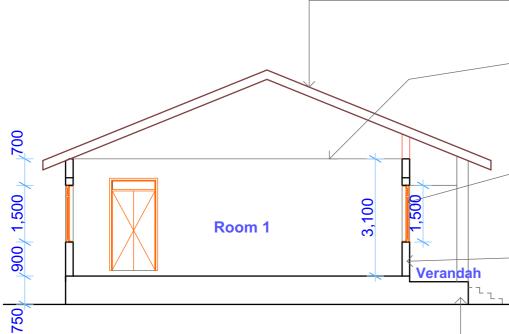

Fenestration:

Windows - steel casement with pvo steel vents Doors - steel plate door with pvo steel vents

Super structure:

Brick walls

Un plastered walls

RC ring beam

RC columns

Walling above ring beam to the columns



Mud floor

Brick walls-un plastered plinth walls

Stone walls-plinth in some walls





CROSS SECTION and PICTURES

Enabel Infrastructure Unit

Legacy Towers, Wing B, 5th Floor Nakasero, Kyadondo Road, Plot 5 P.O.Box 40131, KAMPALA.

Project:

EXISTING GIRL'S DORMITORY AT KAMENGO SECONDARY SCHOOL IN FORT PORTAL

Description:

AS BUILT DRAWING



Notes:	Scale:
	AS SHOWN
	Date:
	MAY. 2024